To view detail " ctrl 1 "

N

Scale: 1" = 80'

0 80' 160' 240' 320'

AS BUILT FLOOR PLAN

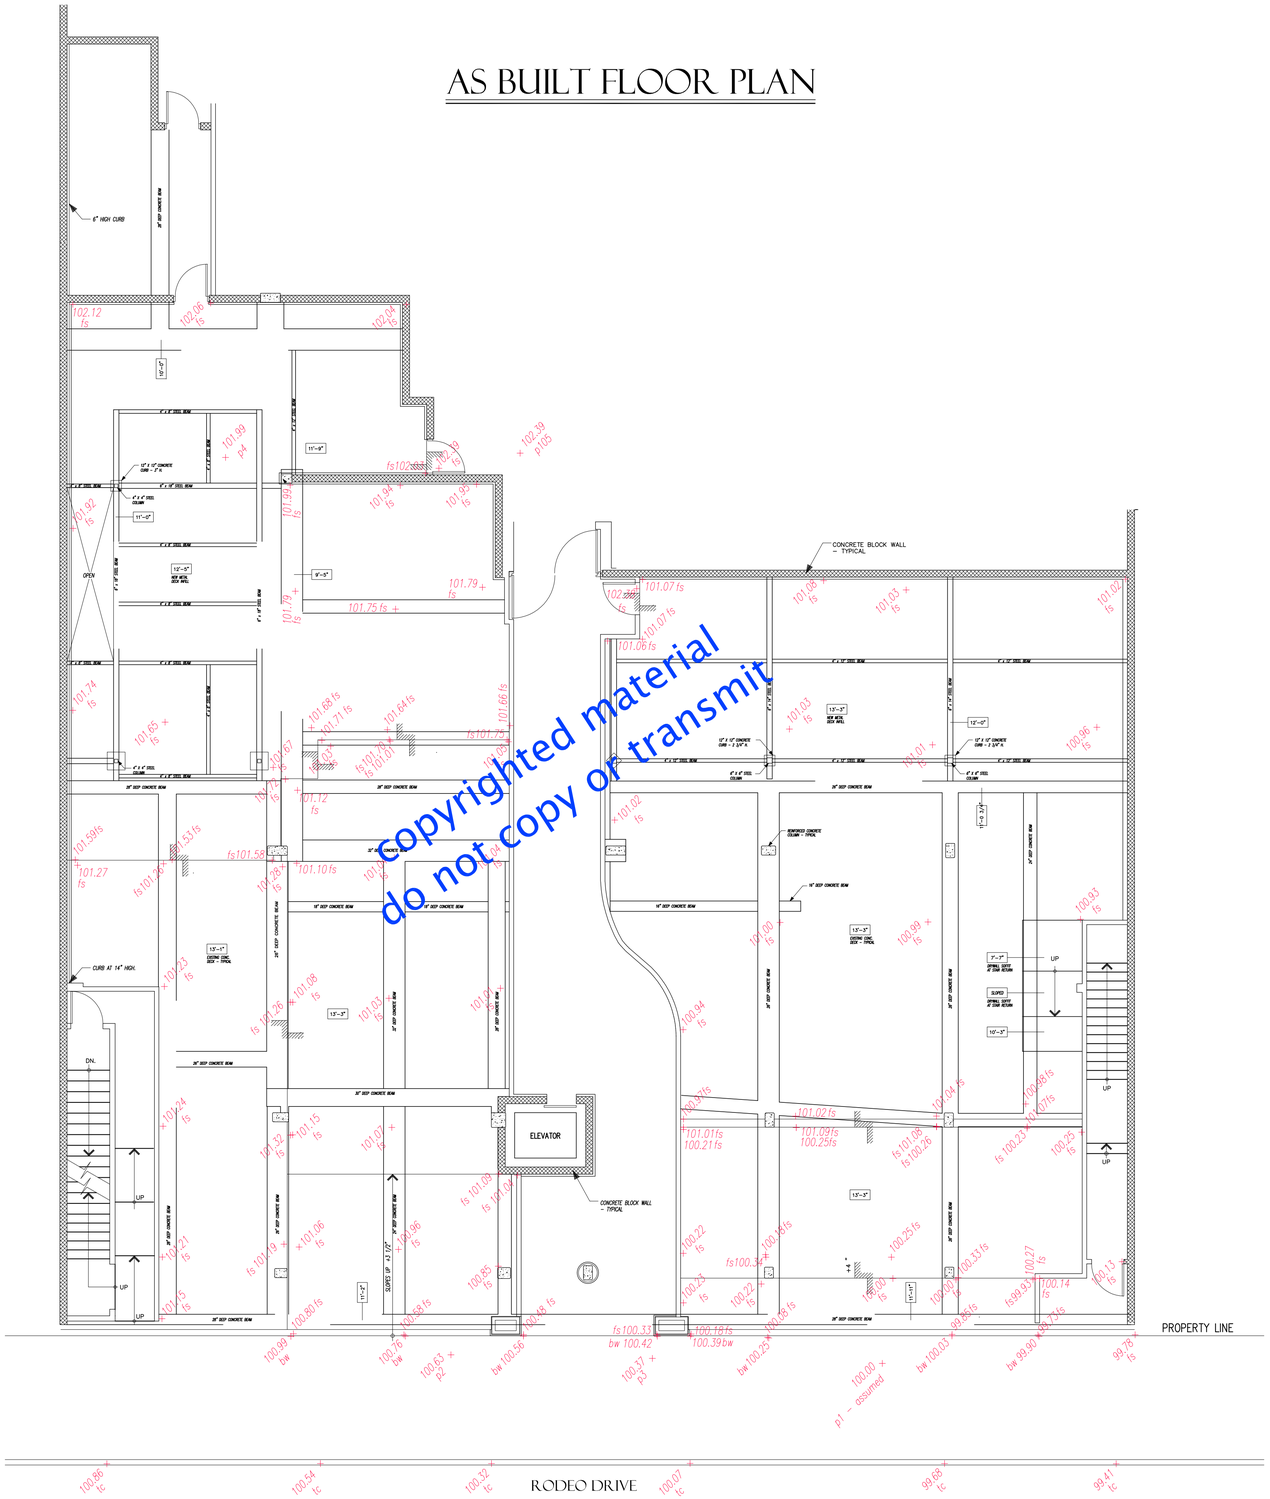

copyrighted material
do not copy or transmit

Legend

conc.	=	concrete
e	=	electric
ff	=	finished floor
fl	=	flowline
fs	=	finished surface
g	=	ground
p1	=	control point 1 (typical)
tc	=	top of curb
ts	=	top of steps
typ.	=	typical

Job site:

. .
. .
. .

PREPARED FOR:

PREPARED BY:

J.O. NELSON
CONSULTING LAND SURVEYORS, INC.
A PROFESSIONAL LAND SURVEYING CORPORATION

11040 SANTA MONICA BL., SUITE 470
LOS ANGELES, CA 90025
(310) 337-1778
WWW.JONELSONCLS.COM